


MANHOLE DRAINAGE SHAFT DETAIL
STATION 3+20
NOT TO SCALE

B.M. 814.07 "PK" IN LEAD IN CURVE OF N.W. CB. RET. OF 12LM & JURUPA. K.B. 925/62


GENERAL CONSTRUCTION NOTES

1. CONSTRUCT MANHOLE PER STD. #31 AS INDICATED BY: AND PER DETAIL AT RIGHT.
2. 24" R.C.P. SHALL BE CLASS 2000-D. BEDDING SHALL BE CASE I PER STD. 452.
3. TRENCH BACKFILL SHALL BE PER STD. 453.
4. EXACT LOCATIONS AND DEPTHS OF UNDERGROUND UTILITIES ARE UNKNOWN. THE LOCATION'S AND DEPTHS SHOWN ON PLAN ARE FROM UTILITY RECORDS. THE CONTRACTOR IS REQUIRED TO TAKE DUE PRECAUTIONARY MEASURES TO LOCATE AND PROTECT ALL UNDERGROUND FACILITIES.
5. ANY FENCE REMOVED SHALL BE RESTORED TO ORIGINAL CONDITION BY CONTRACTOR.
6. CONTRACTOR MAY REMOVE ANY TREES OR SHRUBS FROM WITHIN THE STORM DRAIN EASEMENT WHICH CONFLICT WITH PROPOSED CONSTRUCTION. HOWEVER, NO TREES OR SHRUBS WITHIN THE CONSTRUCTION EASEMENT SHALL BE REMOVED.

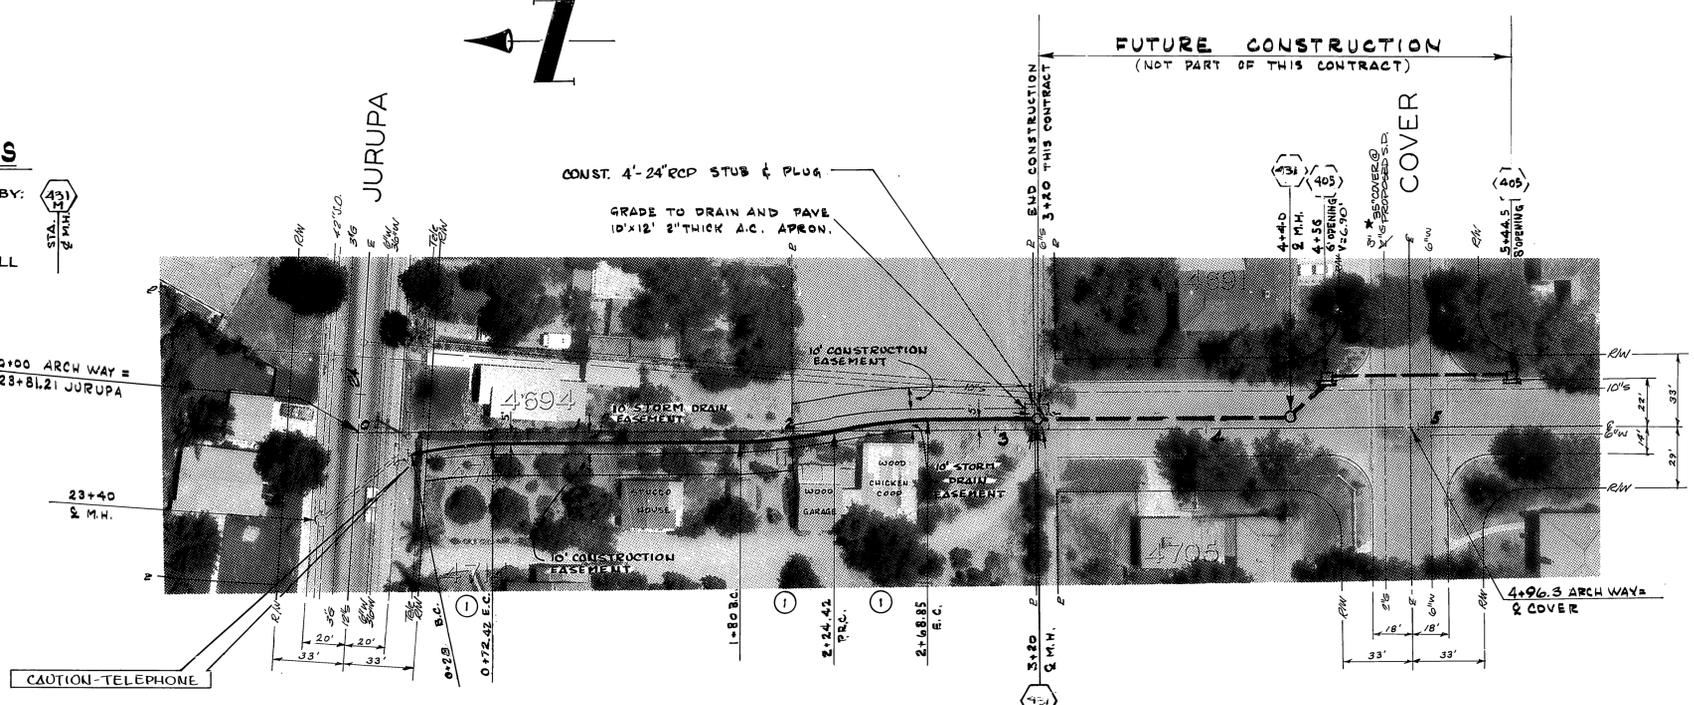

NO.	Δ	R	L	T
(1)	12°50'20"	200'	44.82'	22.50'

ARCH WAY

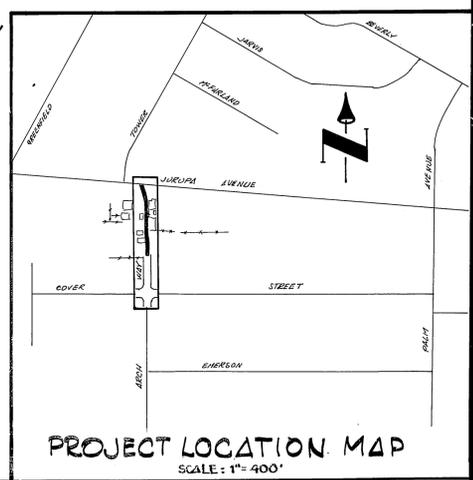

-CAUTION-
PACIFIC TELEPHONE
CABLES UNDERGROUND
BEFORE EXCAVATING
CALL COLLECT:
7:30 A.M. to 5 P.M. & Holidays
Orange County 714-633-0811
Riverside County 714-684-0071

As BUILT 11-21-72 JWB

APPROVED BY	BY DATE	APPROVED BY
PRINCIPAL ENGINEER	6/72	DIRECTOR OF PUBLIC WORKS
PARK DEPARTMENT		
TRAFFIC DIVISION		
CHIEF PUB. WKS. ENGR.	6/19	DATE

DESIGNED BY S.T.B. DRAWN BY JWB CHECKED BY JWB

CITY OF RIVERSIDE, CALIFORNIA
PUBLIC WORKS DEPARTMENT

**ARCH WAY
LATERAL**

HORIZ. SCALE: 1" = 40'
VERT. SCALE: 1" = 4'

ACCOUNT No. 474
DRAWING NUMBER
D - 228
SHEET 1 OF 1